
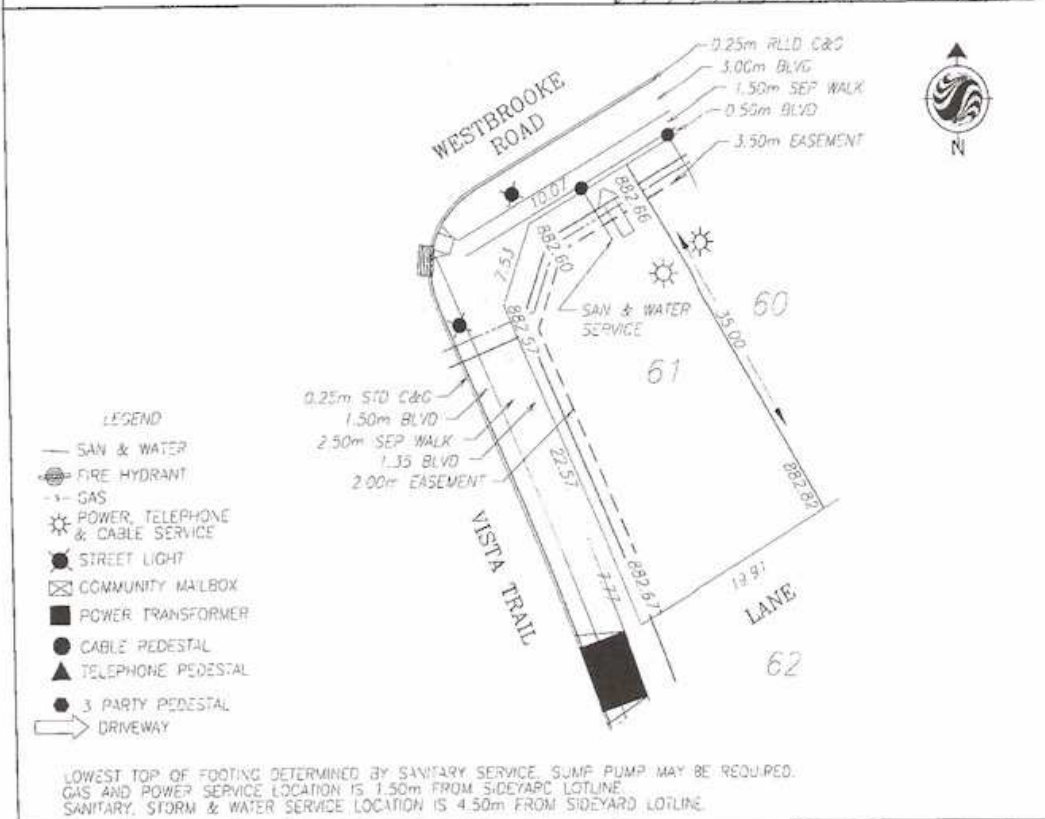


BUILDING GRADE CERTIFICATE

Town of Blackfalds
 Issued by: No.

1. WHEN EXCAVATING IN A RIGHT OF WAY (EASEMENT), CHECK FOR UTILITIES.
2. STANDING AT THE WATER SHUTOFF AND FACING THE BUILDING, THE SANITARY SERVICE (PAINTED RED) IS ON THE LEFT SIDE OF THE WATER SERVICE.
3. ALL DIMENSIONS ARE IN METRES AND DECIMALS THERE OF. THE ELEVATIONS ARE IN METRES ABOVE GEODETIC MEAN SEA LEVEL.
4. ELEVATIONS NOTED ON THE CERTIFICATE ARE WITHIN 100mm OF ACTUAL.
5. THE BUILDER MUST CONSTRUCT WITHIN 100mm OF THE DESIGN LANDSCAPE ELEVATION & ILLUSTRATED DRAINAGE PATTERNS UNLESS OTHERWISE APPROVED BY THE DEVELOPMENT OFFICER.
6. IF THE INFORMATION ON THIS CERTIFICATE HAS BEEN PREPARED BY A PRIVATE DEVELOPER OR THEIR AGENT, THE TOWN OF BLACKFALDS ACCEPTS NO RESPONSIBILITY FOR ITS ACCURACY.

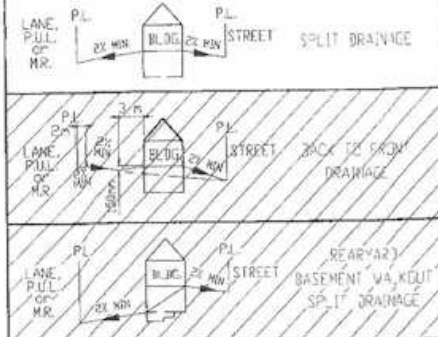

TOP OF FOOTING: MAX. DEPTH BELOW AVERAGE SIDEWALK = 2.07 LOWEST ELEVATION = 880.52	CIVIC ADDRESS: 4201 WESTBROOKE ROAD LOT: 61 BLOCK: 3 PLAN No. 1 DEVELOPER: MALIBU COMMUNITIES LTD. SCALE: 1:500 DRAWN BY: STANTEC CONSULTING LTD. DATE: AUG 14, 2012 APPROVED BY: ALAN FORMAN, P.ENG. DATE: JAN 13, 2013 RECEIVED BY: NAME DATE
AS-BUILT SEWER INVERT ELEVATIONS: SANITARY AT 5.0m INSIDE LOT = 879.69 STORM AT 5.0m INSIDE LOT = --	I CERTIFY THAT THE FINAL LANDSCAPE GRADE WILL BE (FRONT) _____ (REAR) _____ SIGNATURE OF OWNER OR REPRESENTATIVE _____
DESIGN LANDSCAPE ELEVATIONS: ELEV. AT FRONT OF HOUSE = 883.00 ELEV. AT REAR OF HOUSE = 883.15	